



**Tsartlip First Nation**  
P.O. Box 70, #1 Boat Ramp Road  
Brentwood Bay, BC V8M 1R3  
Phone 250.652.3988 - Fax 250.652.3788



---

---

January 20, 2023

**RE: SHAKER CHURCH SEWER UPGRADES Project Starting February 2023**

Attention: ALL COMMUNITY MEMBERS,

Tsartlip Capital Projects, Public Works, and Housing is working to provide municipal sewer services to the Shaker Church area. This area currently has only municipal water and individual septic systems which are in need of replacement. The planned work would make available municipal sewer to the homes in this area, and it is hoped that this work will be completed in 2023.

The initial work is to design the planned sewer which would follow the current water main along the current Right-of-Way ROW on White Rd (see pic below).

The water main to the area was installed a number of years ago, and so brush has grown back over the route. Tsartlip PW will clear the brush within the road ROW adjacent to the water main to re-establish the route to prepare for design of the sewer system. Tsartlip PW will not infringe upon adjacent lands without consent of the landowner, and with the exception of connections to homes, work will be confined within the ROW. This design work will start in February, and will be of short term in the area ( a few of weeks). Adjacent homeowners/landowners will receive a notice of the works.

Once the design has been completed, it is hoped that the construction work will be tendered with the other works of the Brentwood Bay Sewer Upgrades project. in late spring/early summer.



Further announcements will take place once a route has been designed.

If you have any concerns, please email them to me at [capitalprojects@tsartlip.com](mailto:capitalprojects@tsartlip.com) or drop them by the Band Office.

HÍSWŪKE / Thank You,

Brad Janvier  
Director of Capital Projects  
Tsartlip First Nation



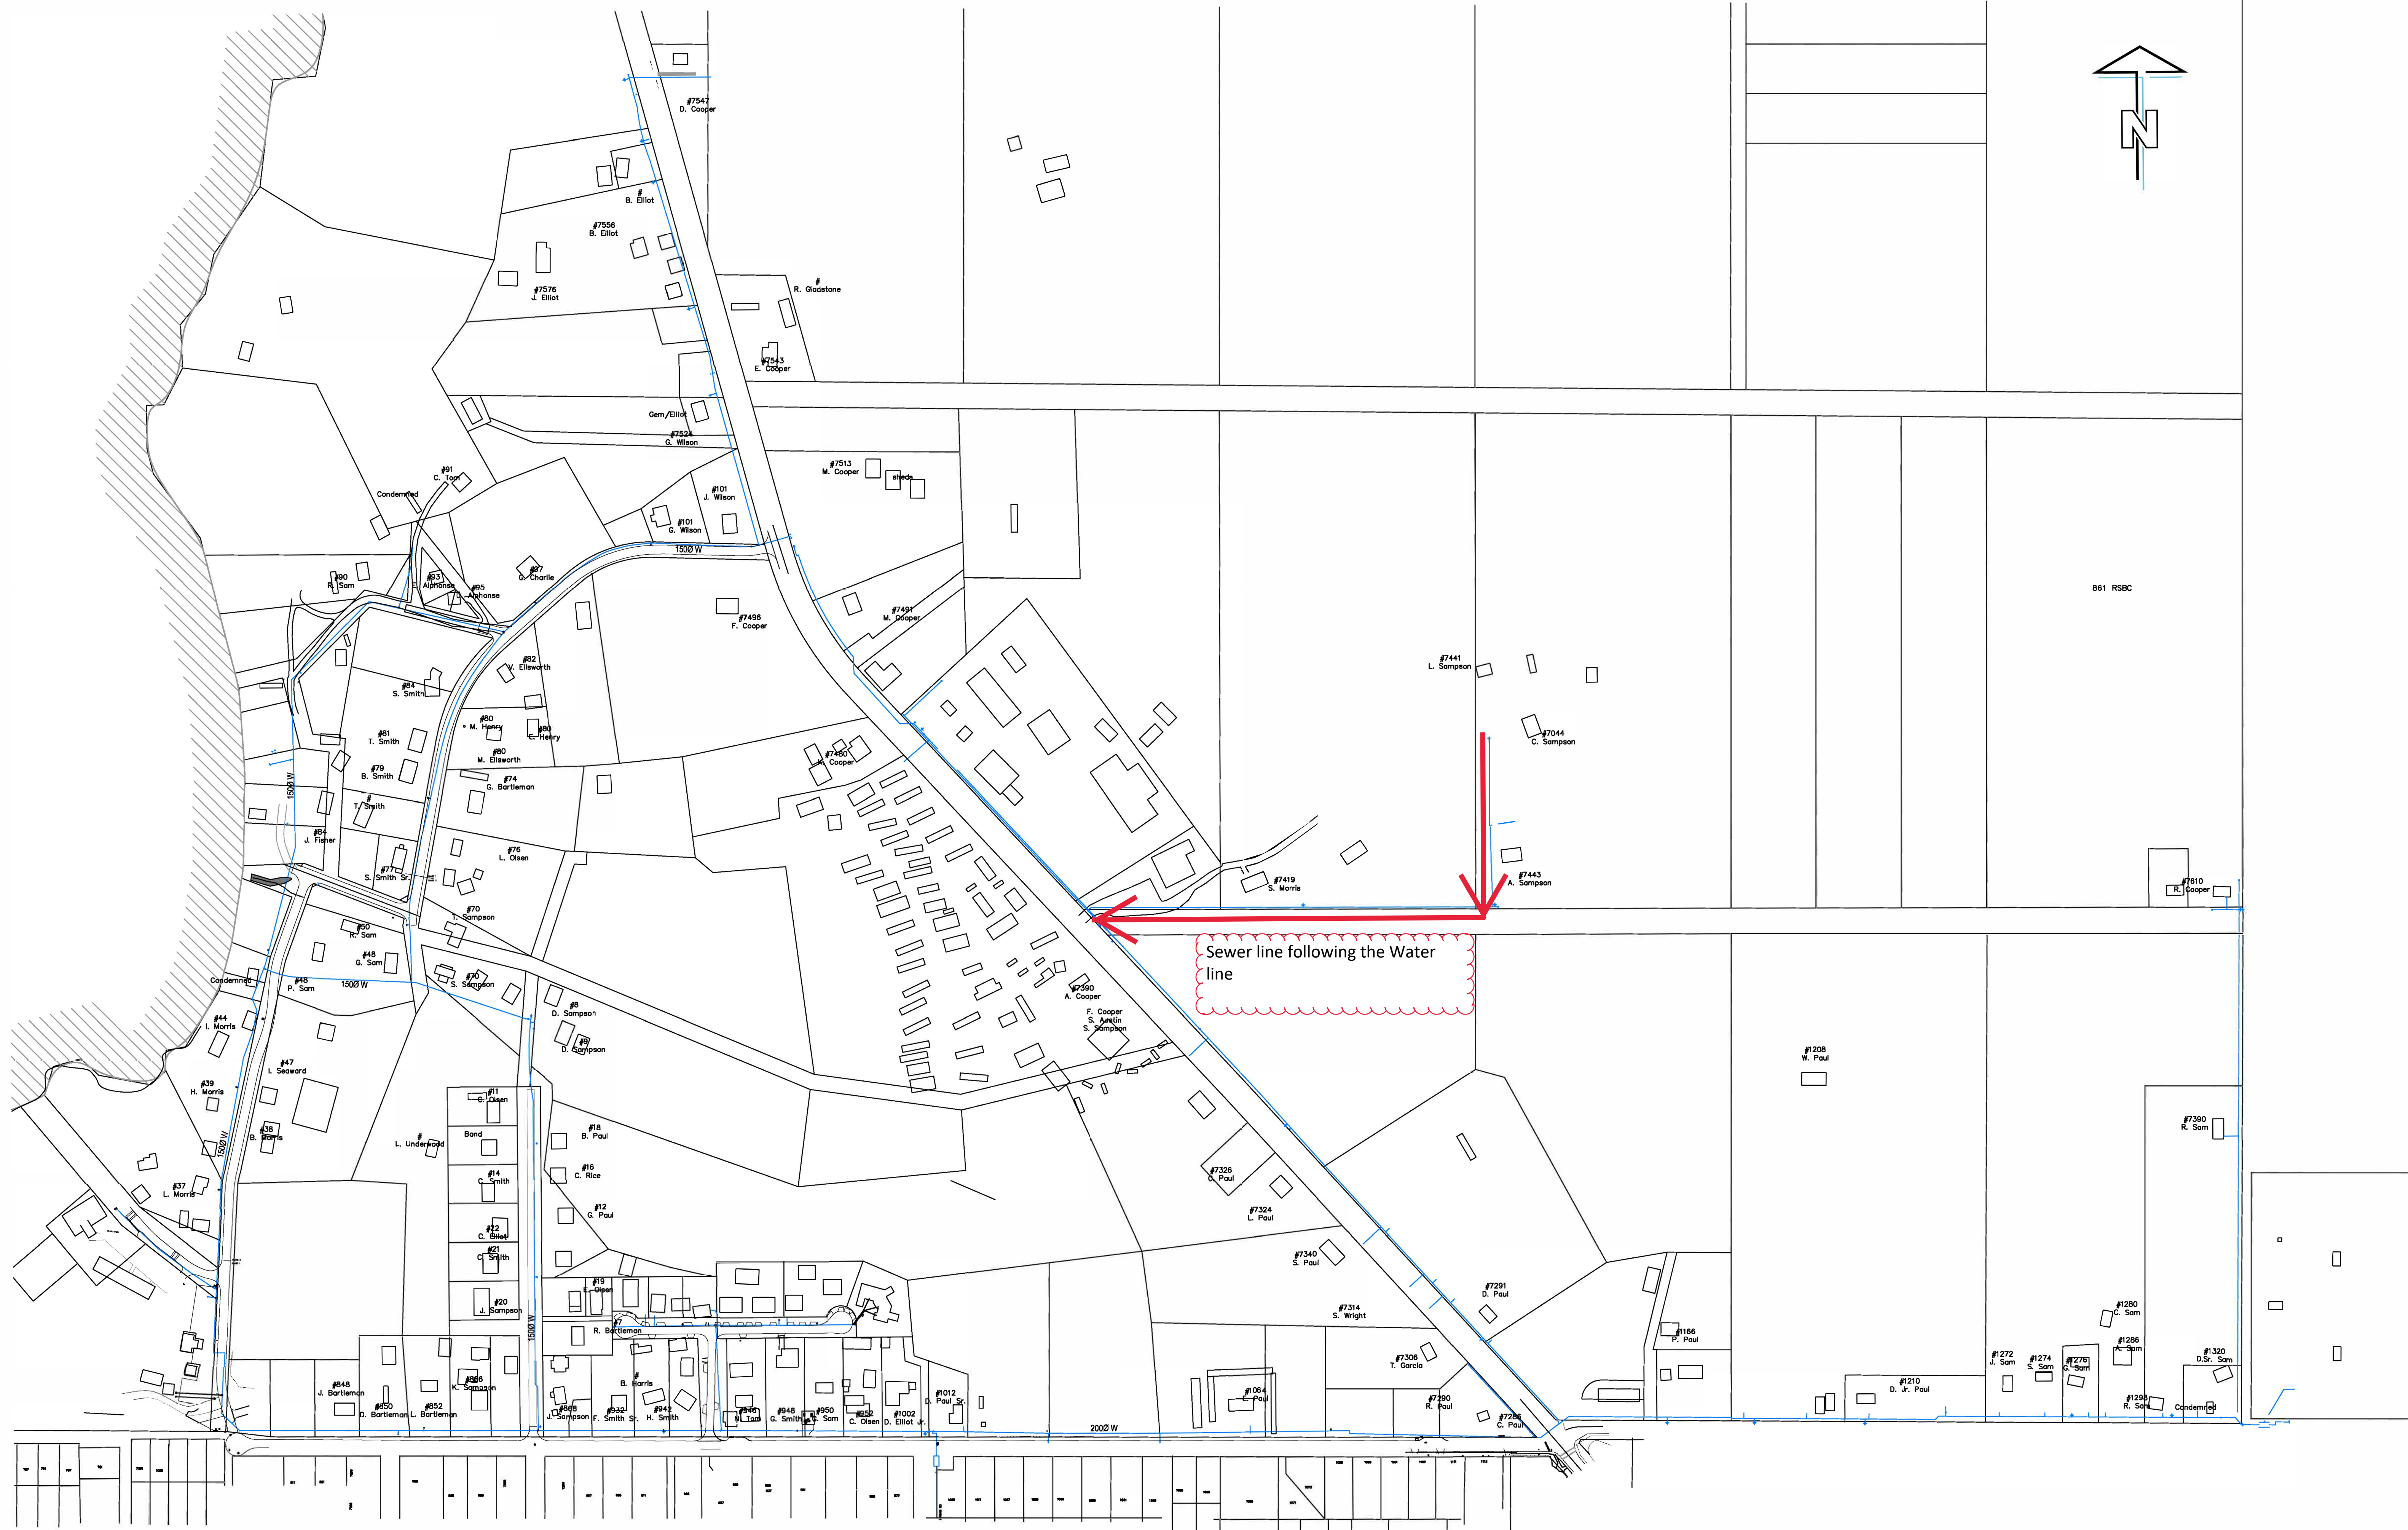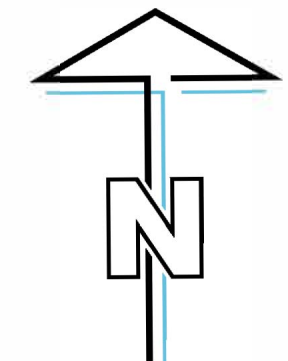

Sewer line following the Water line

861 RSBC

#7610 R. Cooper

#1208 W. Paul

#7390 R. Sam

#1280 C. Sam

#1272 Sam

#1274 S. Sam

#1278 S. Sam

#1288 R. Sam

#1320 D.S. Sam

#1298 R. Sam

Condemned

#166 P. Paul

#1210 D. Jr. Paul







#7306 T. Garcia

#7390 R. Paul

#7286 C. Paul

#7340 S. Paul

#7314 S. Wright

#7291 D. Paul

#7326 L. Paul

#7324 L. Paul




#1064 E. Paul

#1012 D. Paul Jr.

#1002 D. Elliot Jr.

#1032 C. Oaten

#948 G. Smith

#950 Y. Sam

#948 F. Smith Sr.

#932 H. Smith

#948 B. Harris

#848 J. Bartleman

#850 D. Bartleman

#852 L. Bartleman




#18 B. Paul

#16 C. Rice

#12 G. Paul

#11 C. Oaten

#39 H. Morris

#47 I. Seaward

#44 L. Morris

#48 P. Sam

#47 B. Morris




































# Proposed Sewer Main for Shaker Church Subdivision

Preliminary Draft only as confirmation needed on elevations and design.

### Legend

- 📍 ?ÁU, WEL?EW? Tribal School
- 📐 Exterior Boundary
- 📌 Feature 1
- ⦿ LOT
- 📍 Mack Law Corporation
- 🔴 Proposed Sewer Main for Shaker Church Subdivision
- 📍 Rishelle's Home Baking
- 📍 Square One Salvage

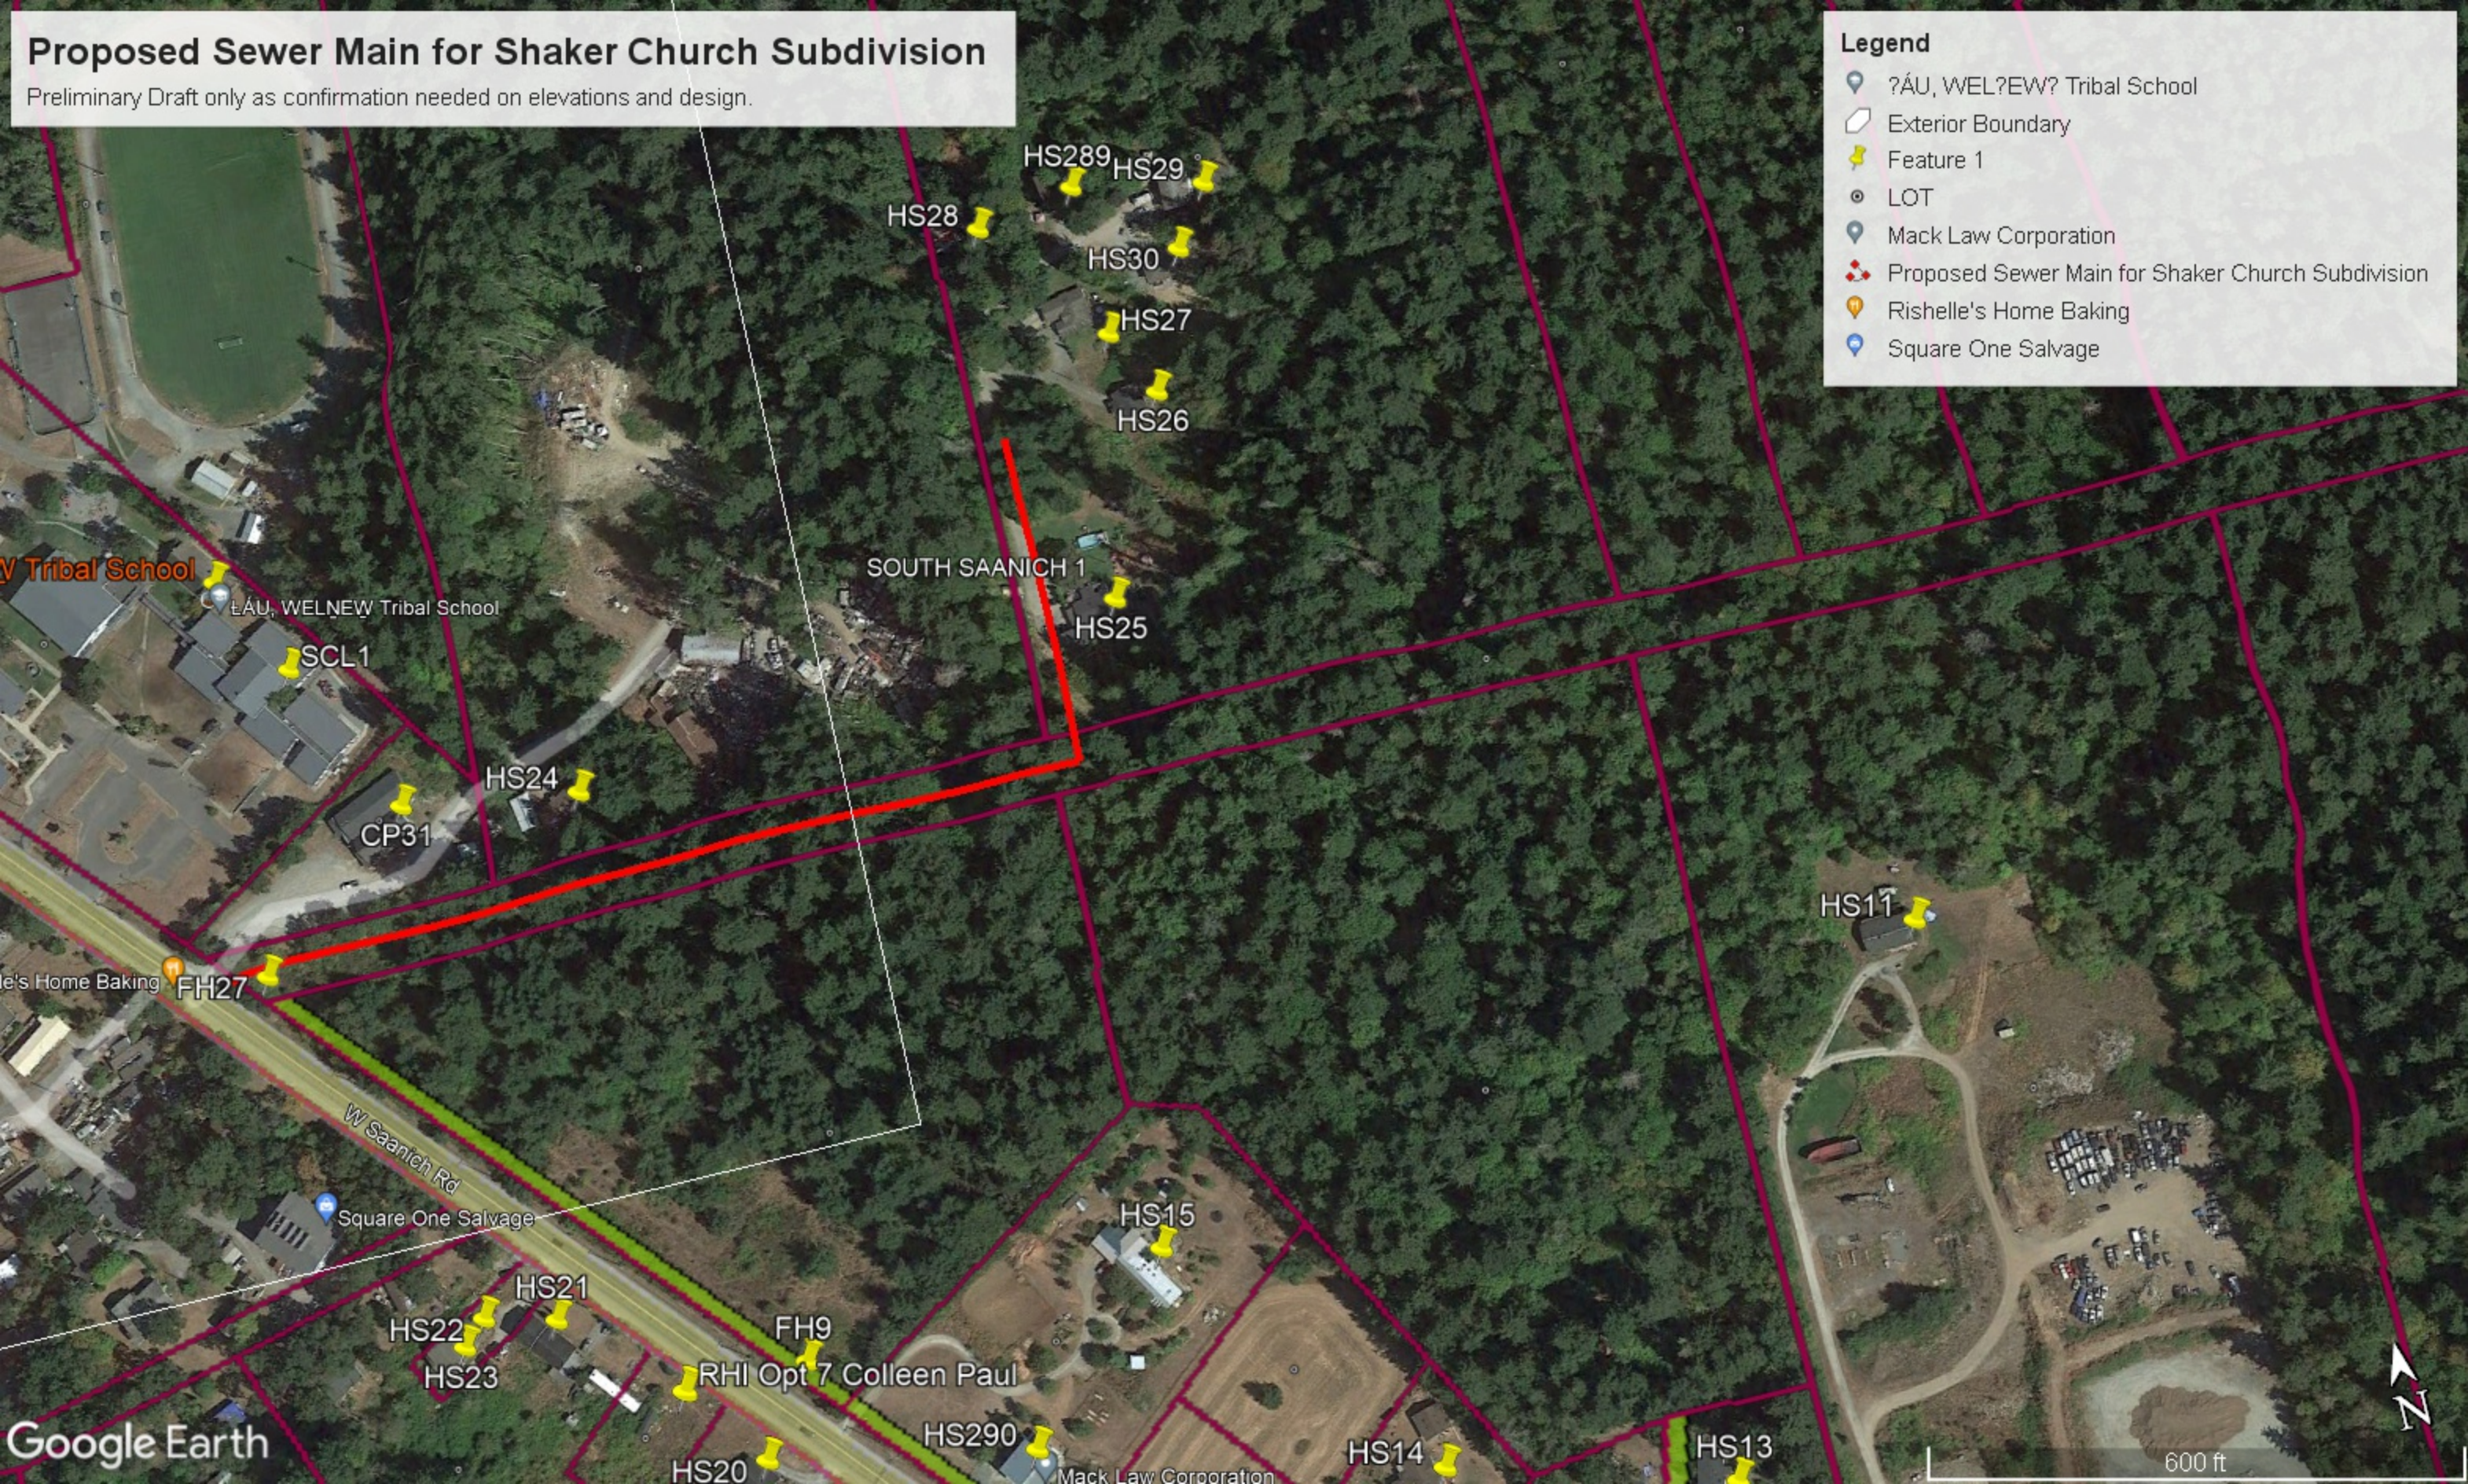

W Saanich Rd

Google Earth

600 ft

